
	DOOR SYMBOL COORDINATE WITH DOOR SCHEDULE
	WALL TYPE COORDINATE WITH DRAWING & BUILDING INFORMATION SHEET
	WINDOW TYPE COORDINATE WITH FRAME TYPES SHEET
	NEW PAINTED SEMI-RECESSED FIRE EXTINGUISHER CABINET AND EXTINGUISHER. PROVIDE DOT ROEMER CABINET #1700 DOOR TYPE "A" AND MULTI-PURPOSE FIRE-CHEMICAL U.L. RATED MP14-A-60BC (10LB.) OR EQUIVALENT. REFER TO DRAWING AND BUILDING INFORMATION SHEET FOR MOUNTING HEIGHT.
	STEEL STUD WALL AND GYPSUM BOARD WALL COORDINATE WITH WALL TYPES.
	CARD READER
	FLOOR DRAIN COORDINATE WITH PLUMBING DRAWINGS
	EXISTING


Project:
CWI BUILDING

Sheet:
LEVEL 01 - TI COMPOSITE
FLOOR PLAN

A circular professional engineer seal for the State of Idaho. The outer ring contains the text "LICENSED ARCHITECT" at the top and "STATE OF IDAHO" at the bottom. Inside the ring, the name "DANIEL J. DANIELS" is printed, followed by "MAY 2016" and "MECHANICAL". A blue ink signature is written across the center of the seal, and the license number "25266" is handwritten in blue ink below the signature.

Project No:	23008-
Drawn By:	H
Checked By:	F
Date:	6/25/20

A2.11t

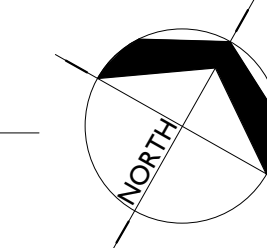

A diagram of a polygon divided into two regions, AREA A and AREA B, by a vertical red line. AREA A is on the left and AREA B is on the right.

E1 LEVE
A2.11t 1/8" = 1'-0"


A

B

C

D

E

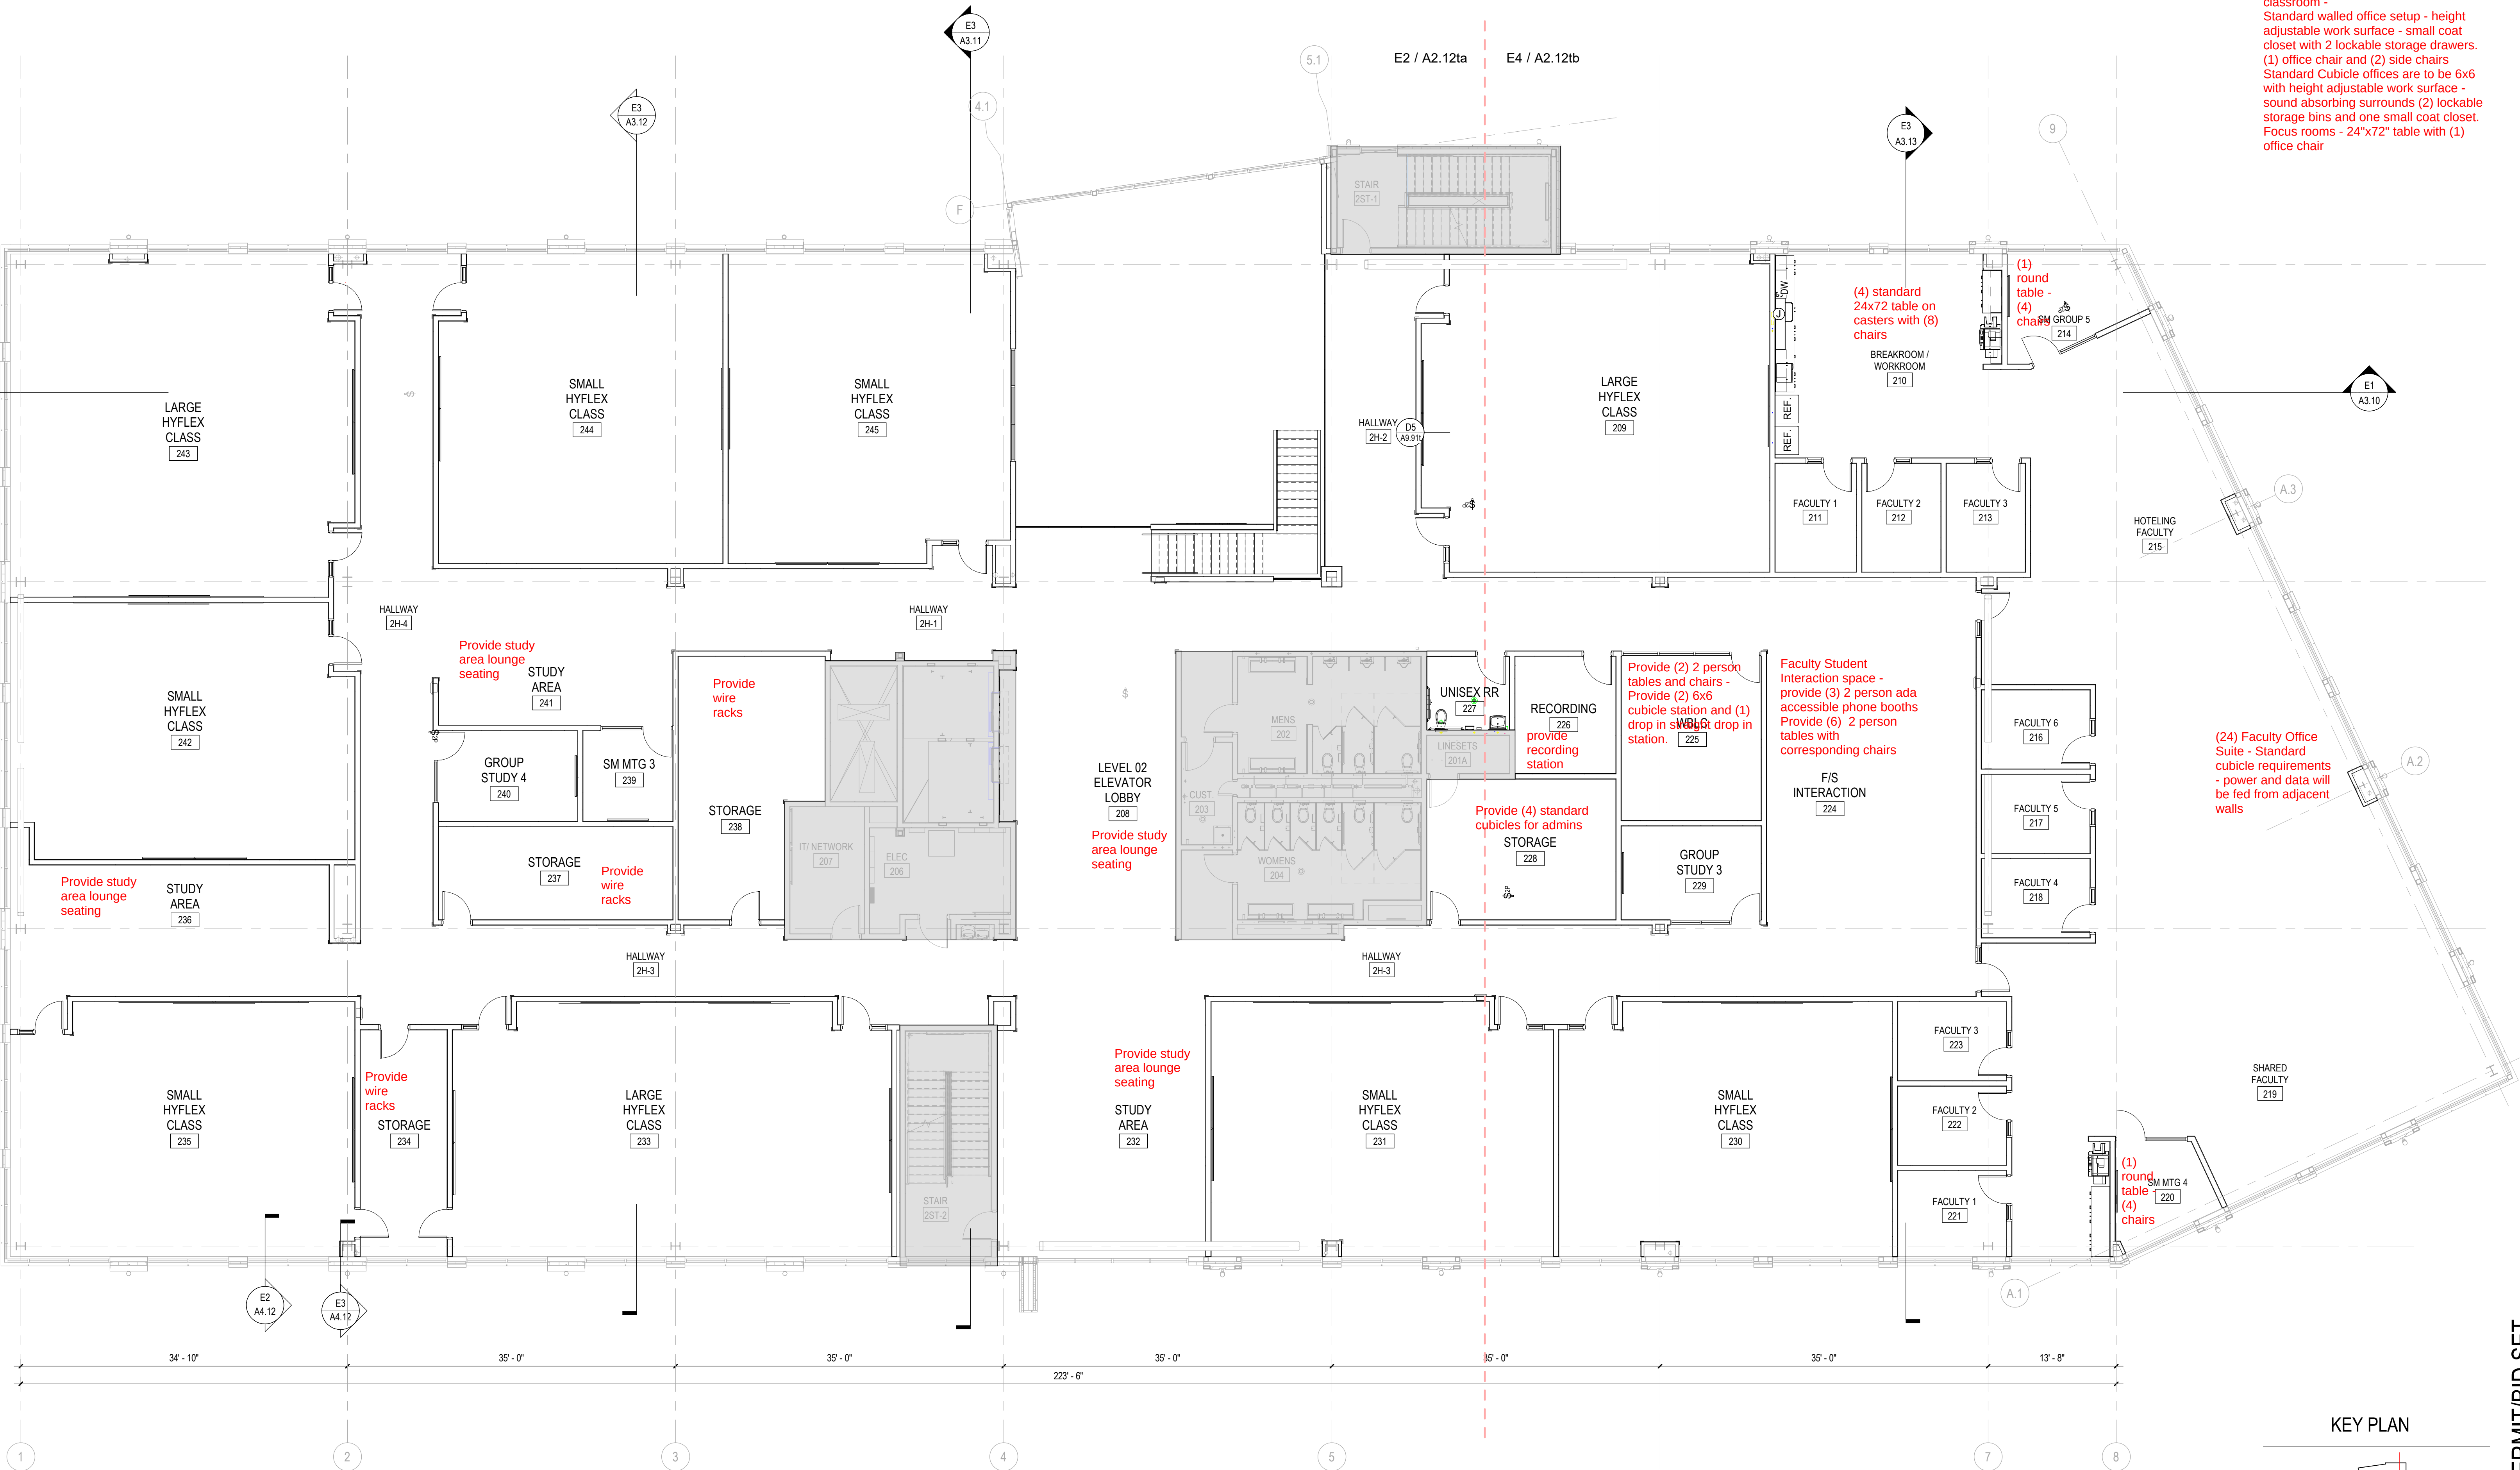


E1 LEVEL 02 - TI COMPOSITE FLOOR PLAN
A2.12t 1/8" = 1'-0"

General Seating Guidelines unless noted otherwise
Classroom desks to be 24"x72" with casters
Classroom/seating table chairs will not have arms
Classroom seating to have casters and have a padded seat.
Large Hyflex classrooms to have tiered seating with 3 levels - tallest "backrow" can have desks with feet and chairs/stools with slides or casters.
No consoles will be required in any of the classroom.
Standard walled office setup - height adjustable work surface - small coat closet with 2 lockable storage drawers.
(1) office chair and (2) side chairs
Standard Cubicle offices are to be 6x6 with height adjustable work surface - sound absorbing surrounds (2) lockable storage bins and one small coat closet.
Focus rooms - 24"x72" table with (1) office chair

(24) Faculty Office Suite - Standard cubicle requirements - power and data will be fed from adjacent walls

KEY PLAN

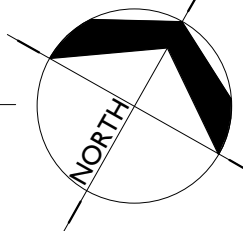

GENERAL NOTES

- A. THE COMPOSITE PLANS ARE INTENDED TO SHOW OVERALL LAYOUT. RE: AREA PLANS FOR ADDITIONAL INFORMATION.
B. PLAN WALL DIMENSIONS ARE TO GRID LINE OR FACE OF WALL. STRUCTURE. "CLEAR" DIMENSIONS ARE TO FACE OF WALL FINISH.
C. FIELD VERIFY ALL EXISTING CONDITIONS AND THEIR COMPATIBILITY WITH NEW CONSTRUCTION PRIOR TO THE COMMENCEMENT OF WORK. COORDINATE DISCREPANCIES WITH ARCHITECT.
D. DO NOT SCALE DRAWINGS.
E. SEE CIVIL, STRUCTURAL, MECHANICAL AND ELECTRICAL DRAWINGS FOR MORE INFORMATION.
F. SEE G SERIES SHEETS FOR WALL TYPES AND TYPICAL ACCESSIBILITY CLEARANCE AND COMPLIANCE REQUIREMENTS.

KEYNOTES

REFERENCE NOTES

LEGEND

- (101) DOOR SYMBOL COORDINATE WITH DOOR SCHEDULE
XXXXXXX WALL TYPE, COORDINATE WITH DRAWING & BUILDING INFORMATION SHEET.
(SF-01) WINDOW TYPE, COORDINATE WITH FRAME TYPES SHEET.
NEW PAINTED SEMI-RECESSED FIRE EXTINGUISHER CABINET AND EXTINGUISHER. PROVIDE POTTER ROEMER CABINET #1700 DOOR TYPE 'A' AND MULTI-PURPOSE DRY-CHEMICAL U.L. RATED MP10 4A-60BC (10LB) OR EQUAL. REFER TO DRAWING AND BUILDING INFORMATION SHEET FOR MOUNTING HEIGHT.
STEEL STUD WALL AND GYPSUM BOARD WALL. COORDINATE WITH WALL TYPES.
CR CARD READER
E3 FLOOR DRAIN. COORDINATE WITH PLUMBING DRAWINGS.
EXISTING


HUMMEL
ARCHITECTS
205 N. 10th Street Suite 300 Boise, Idaho 83702 208.343.7023
452 Constitution Way, Suite 101 Idaho Falls, ID 83402 208.343.7023
hummelarch.com

Project:
CWI BUILDING

WHITEWATER BLVD & MAIN ST.
BOISE, IDAHO

Sheet:
LEVEL 02 - TI COMPOSITE
FLOOR PLAN

PERMIT/BID SET

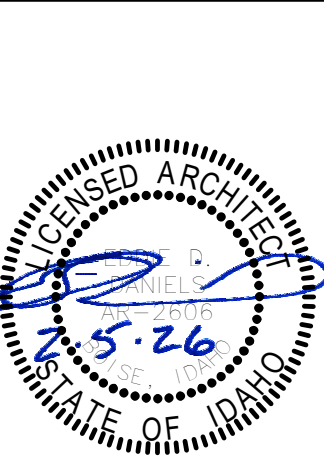

Revisions:		
1	ADDENDUM 001	7/11/2025
2	ASI-01	8/13/2025
3	CITY RESUBMITTAL 3	12/19/2025
4	ASI-10	4/1/2026

Project No: 23006-12
Drawn By: HA
Checked By: PR
Date: 6/25/2025

Sheet No:
A2.12t

9.02	ALIGN WALL PLANES.
10.05	MAX OCCUPANCY SIGN


	DOOR SYMBOL COORDINATE WITH DOOR SCHEDULE
	WALL TYPE, COORDINATE WITH DRAWING & BUILDING INFORMATION SHEET.
	WINDOW TYPE, COORDINATE WITH FRAME TYPES SHEET.
	NEW PAINTED SEMI-RECESSED FIRE EXTINGUISHER CABINET AND EXTINGUISHER. PROVIDE POTTER ROEMER CABINET #1700 DOOR TYPE 'A' & MULTI-PURPOSE DRY-CHEMICAL U.L. RATED MP101-A-60BC (10LB.) OR EQUAL. REFER TO DRAWING AND BUILDING INFORMATION SHEET FOR MOUNTING HEIGHT.
	STEEL STUD WALL AND GYPSUM BOARD WALL. COORDINATE WITH WALL TYPES.
	CARD READER
	FLOOR DRAIN. COORDINATE WITH PLUMBING DRAWINGS
	EXISTING

Project:
CWI BUILDING THIRD FLOOR
TI

Sheet:
LEVEL 03 - TI FLOOR PLAN

DANIEL S. ZIBUS
5265
12/31/2019
STATE OF IDAHO

Sheet No:
3T|-A2.13

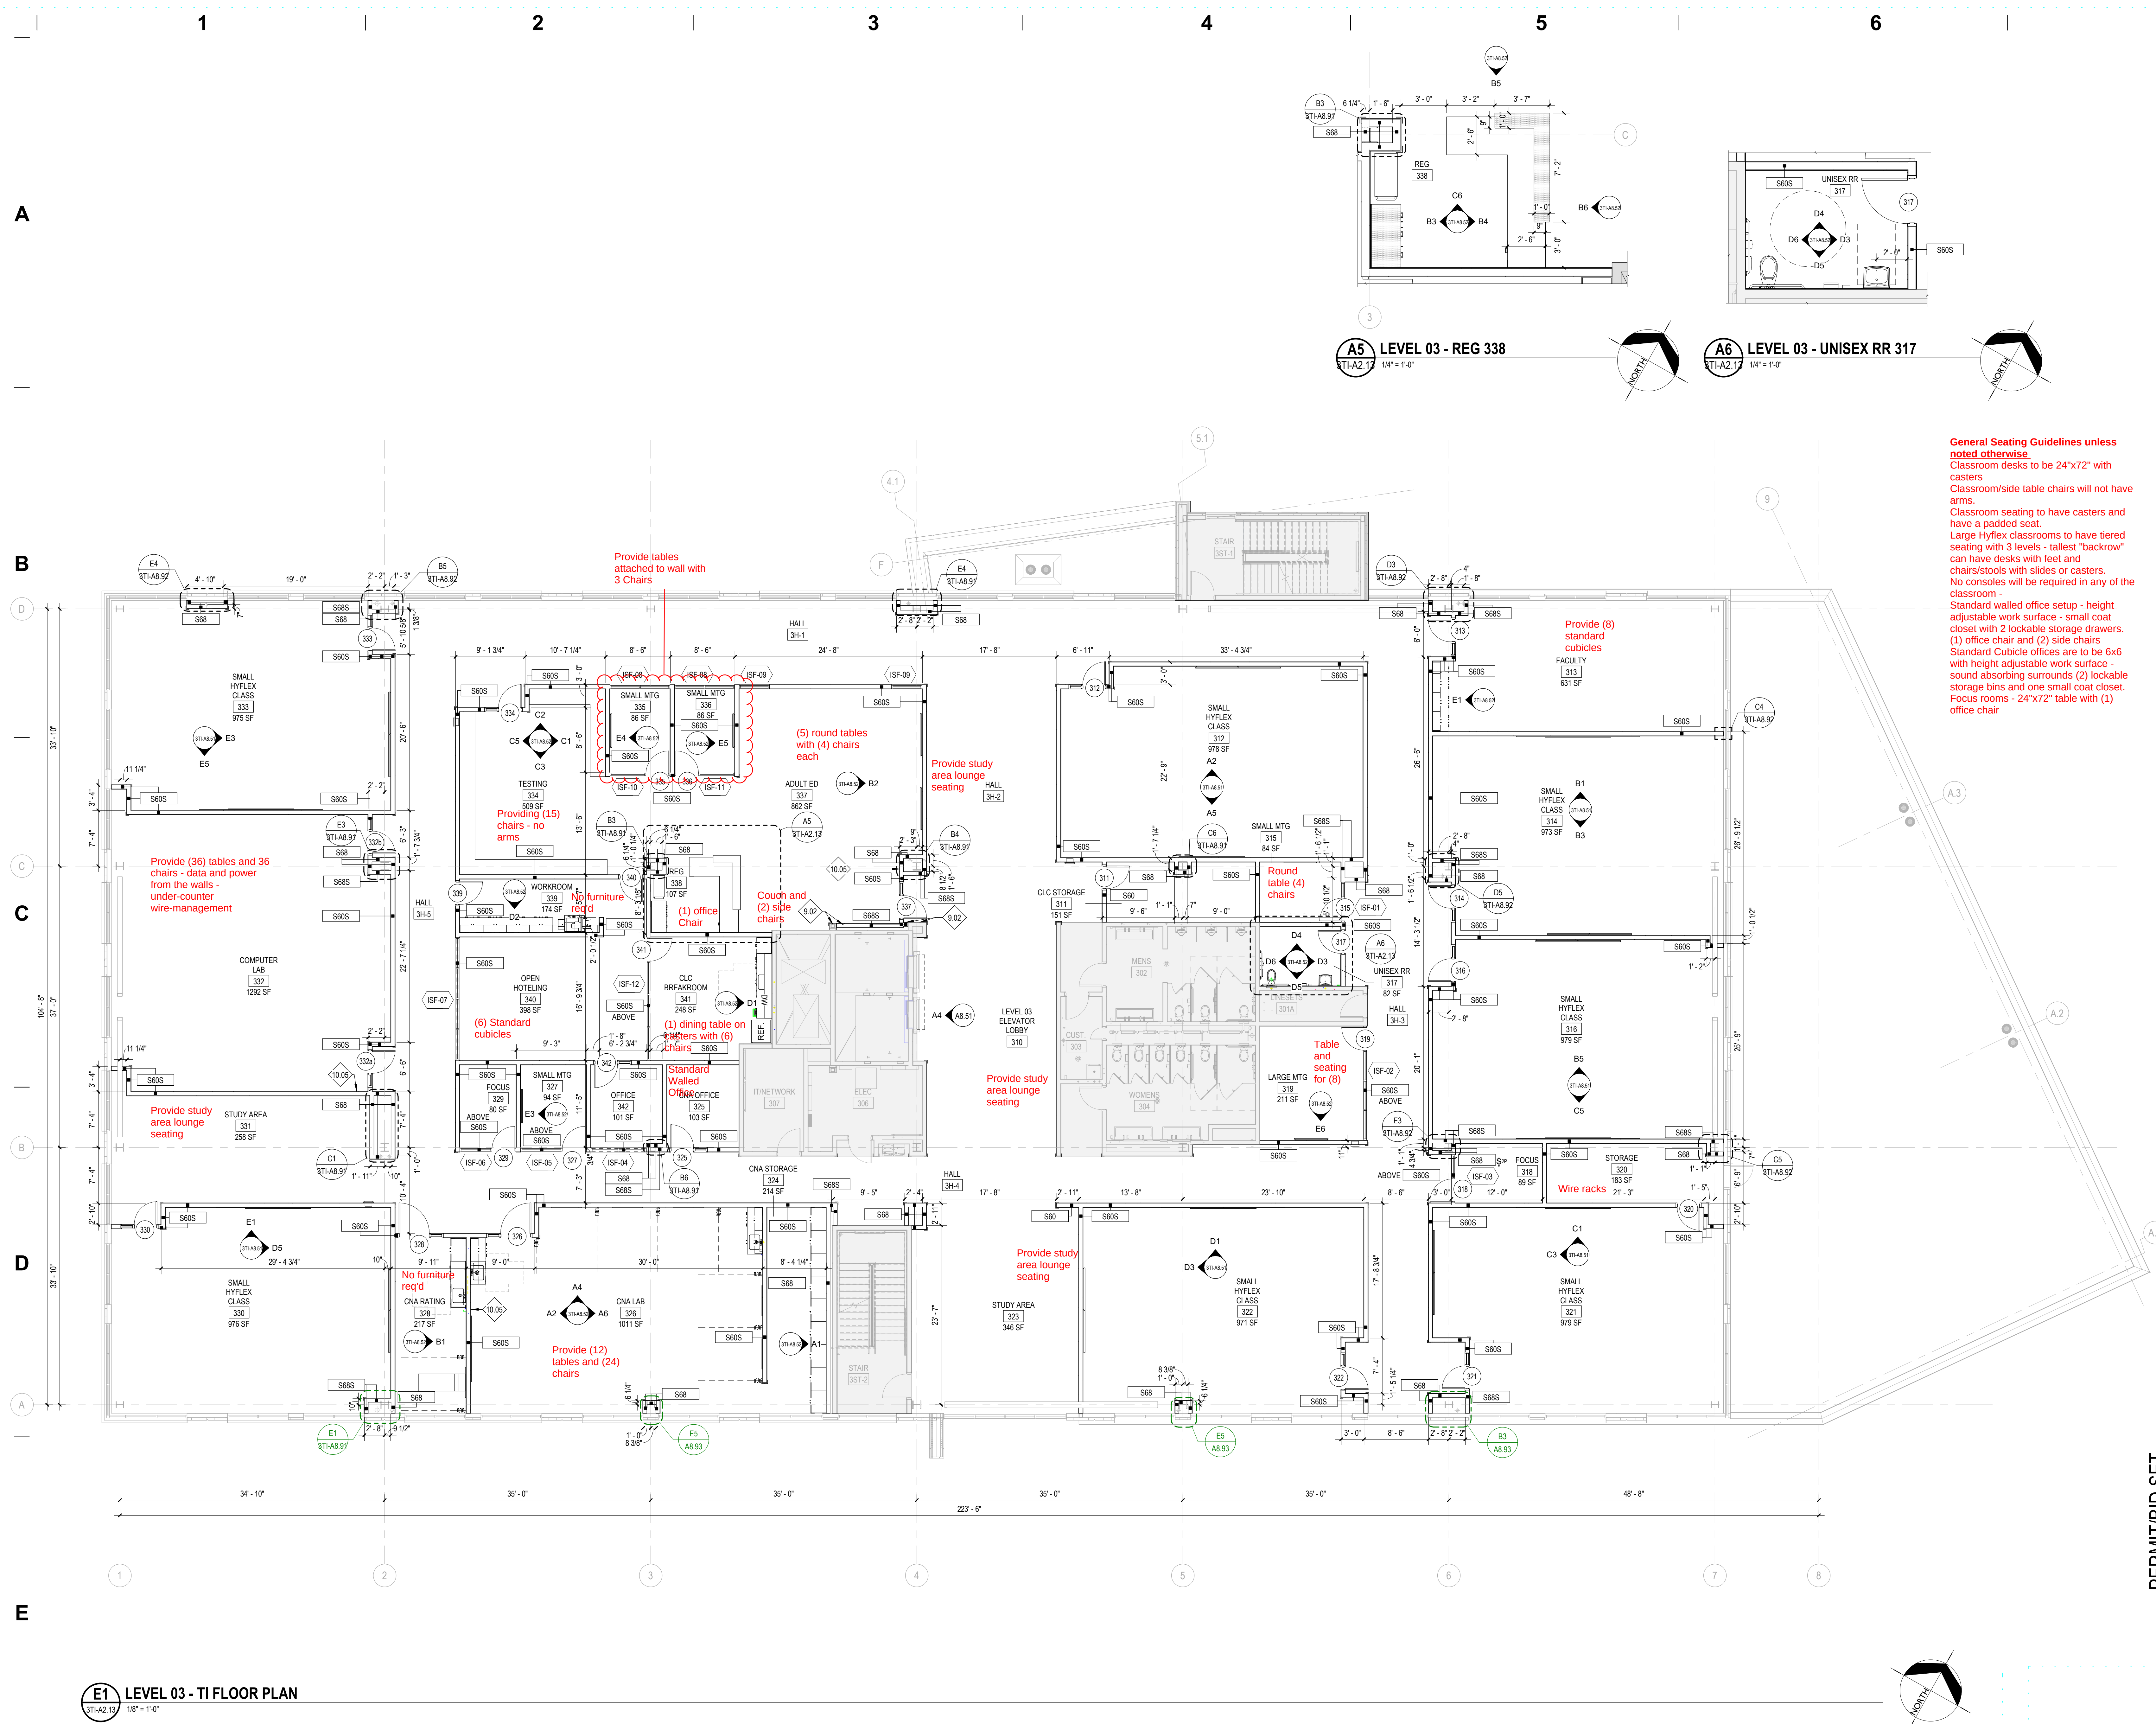

E1 LEVEL 03 - TI FLOOR PLAN
3TI-A2.13 1/8" = 1'-0"